

**Note**  
Pool excavation shall be inspected by soils engineer prior to steel placement. As a condition of the use of Pool Engineering, Inc. structural plans, Soils Engineer shall certify that the pool bottom conforms to Structural Note 1 on Standard Pool Structural Plan.

**SCOPE OF WORK**  
1 - NEW SWIMMING POOL (230 SQ.FT.)  
2 - NEW SFT CMU SW. POOL EQUIPMENT SCREENING WALL  
SITE PLAN NOTES  
1 - POOL SHALL BE PLUMBED FOR FUTURE SQAUR  
2 - NEW SWIMMING POOL/SPA HEATER SHALL BE INSTALLED  
CUT/FILL CALCULATIONS  
SWIMMING POOL CUT(BANK YARDS)... 24 CU.YDS.

**CONTRACTOR**  
WATERWORX POOLS INC.  
2022 FASHION LANE SUITE 219  
TUSTIN, CA 92780  
TELE: 714-714-0424  
EMAIL: INFO@WATERWORXPOOLS.COM  
CA LIC: 10593336  
CLASS: C-53

**DESIGNER**  
MELAYNE YOUCUM  
310-428-9863  
2357 VIA ANACAPA  
PALOS VERDES ESTATES, CA 90274


5 SWIMMING POOL & SPA PLAN

7 SECTION - SW. POOL ENCLOSURE WALL

2 DROWNING PREVENTION MEASURE - DOOR ALARM

3 DROWNING PREVENTION MEASURE - SONAR ALARM

4 UTILITIES - NAT. GAS & ELECTRICAL TRENCHING

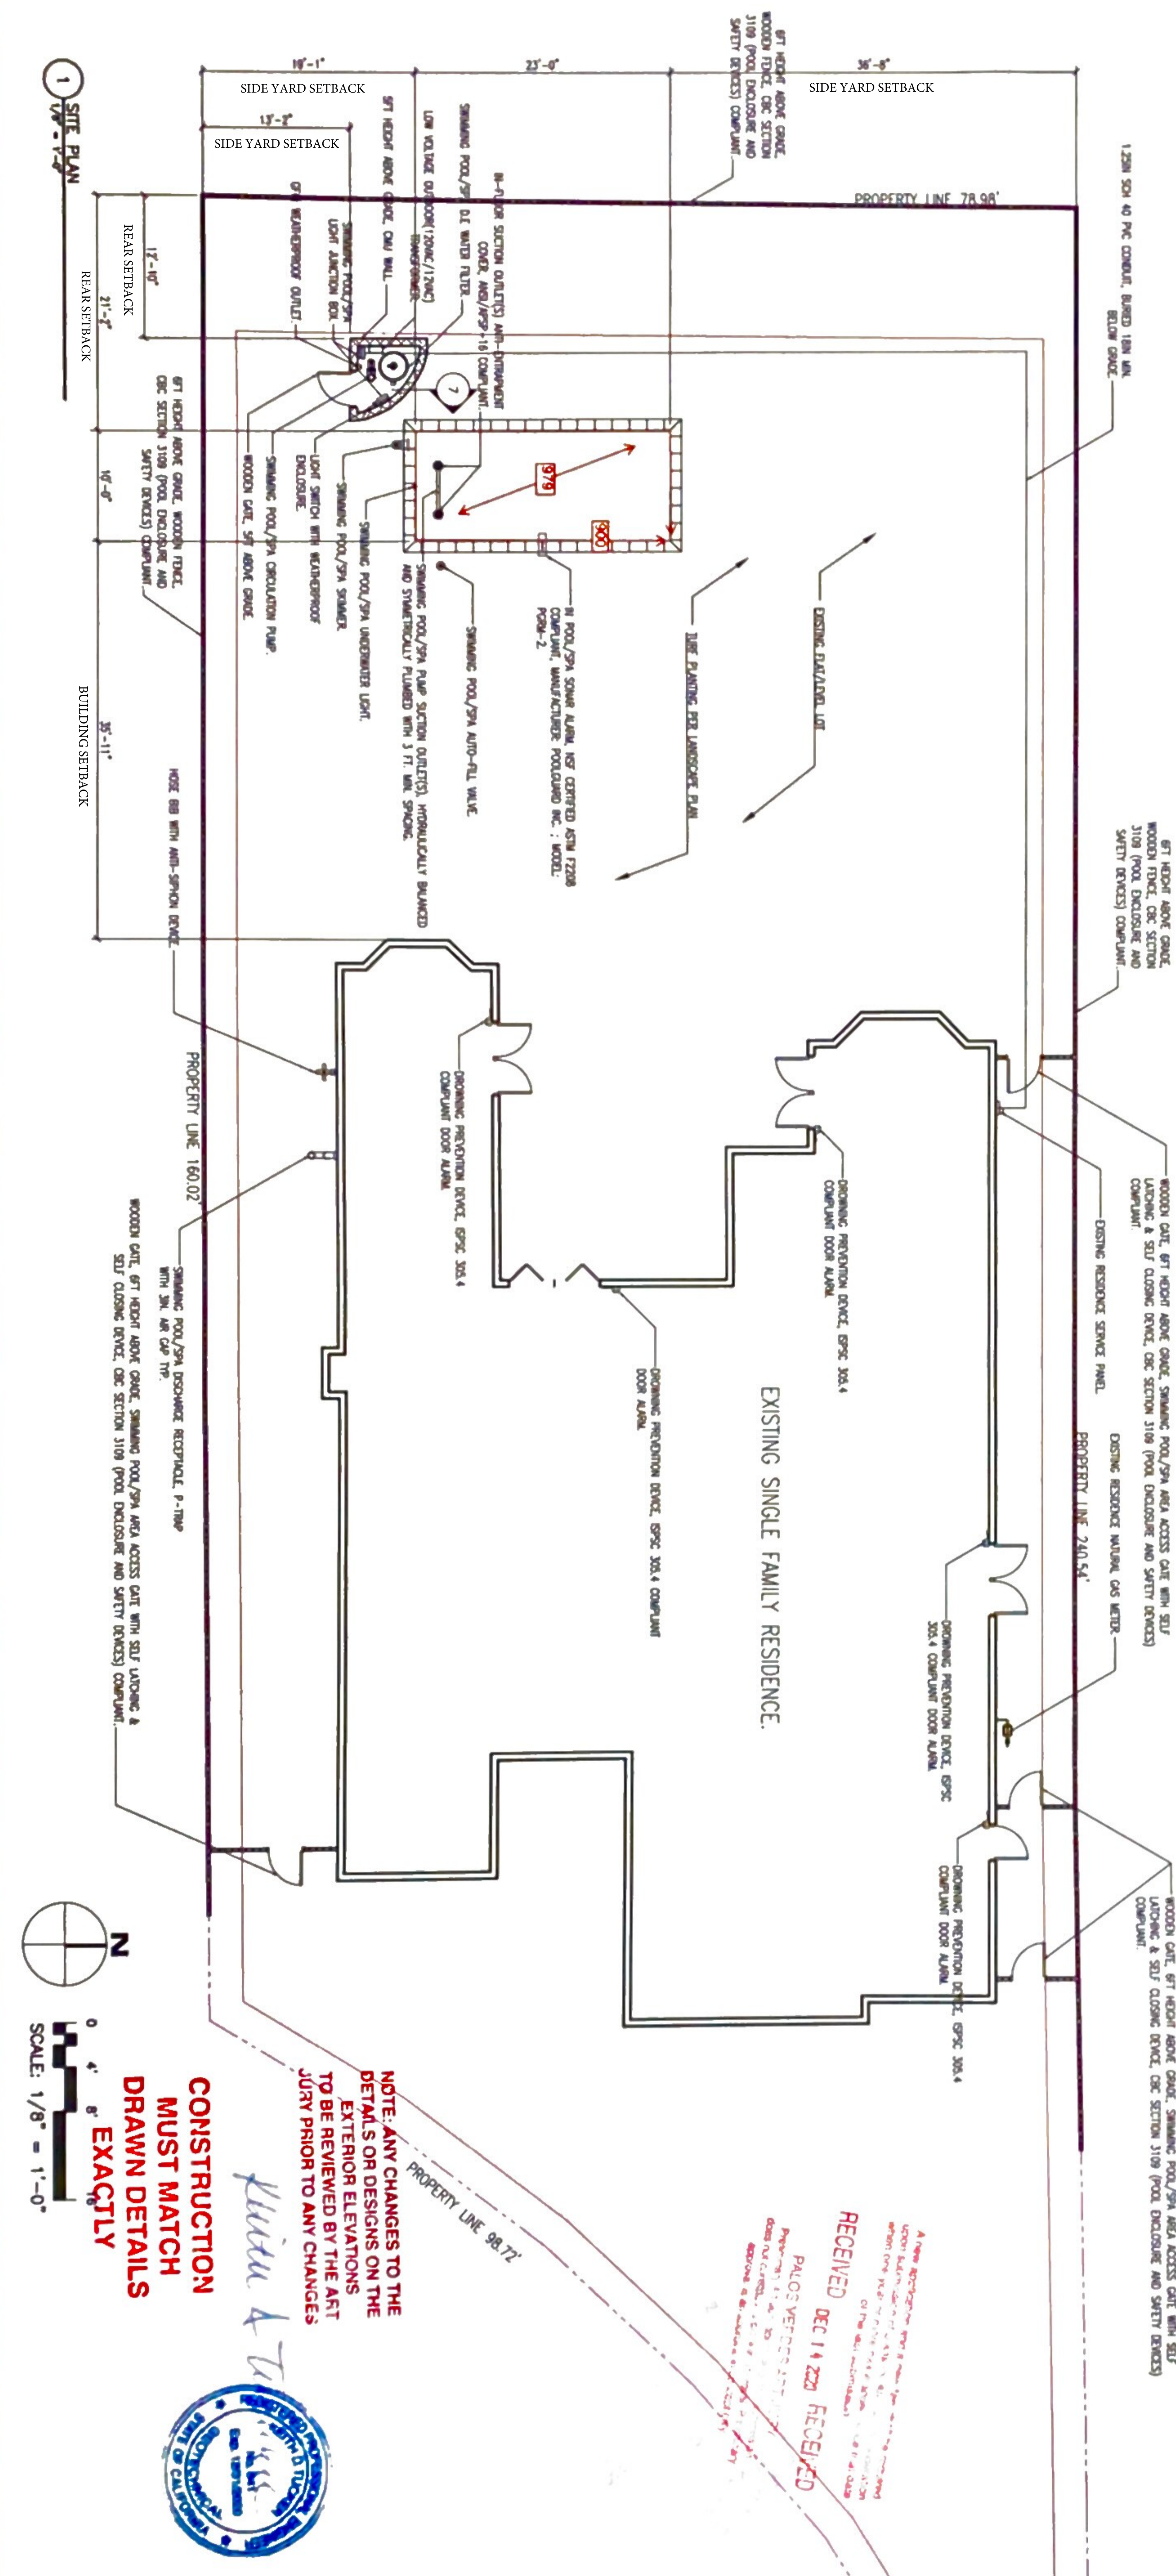


PROJECT NAME	YOUCUM RESIDENCE - NEW SWIMMING POOL
PROJECT DESCRIPTION	NEW SWIMMING POOL CONSTRUCTION
PROJECT ADDRESS	2357 VIA ANACAPA PALOS VERDES ESTATES, CA 90274
DATE	12/9/20
DRAWN BY	ML
CHECKED BY	ML
SCALE	1/8" = 1'-0"
SHEET TITLE	SITE PLAN
SHEET NO.	L-11



RECEIVED DEC 14 2020 RECEIVED  
PALOS VERDES ESTATES  
2357 VIA ANACAPA  
PALOS VERDES ESTATES, CA 90274  
DATE OF RECEIPT: 12/14/20  
BY: [Signature]

NOTE: ANY CHANGES TO THE DETAILS OR DESIGNS ON THE EXTERIOR ELEVATIONS TO BE REVIEWED BY THE ART JURY PRIOR TO ANY CHANGES

CONSTRUCTION MUST MATCH DRAWN DETAILS EXACTLY

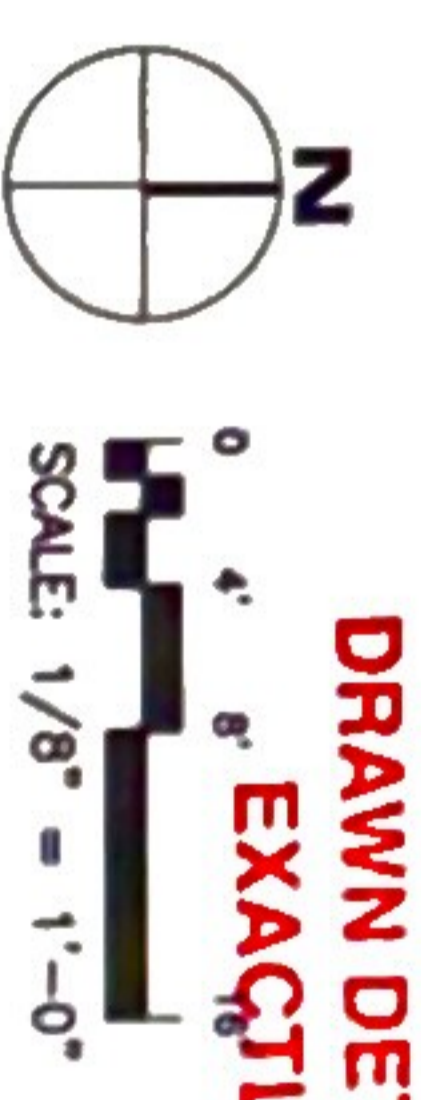



# CALCULATIONS

## METHODOLOGY:

$\gamma$  = EQUIVALENT FLUID PRESSURE

**RESISTING MOMENT:**  
RESISTING MOMENT ABOUT POINT A  
 $R_M = W_1 d_1 + W_2 d_2 + \dots + W_n d_n$

**CASE I**  
OTM =  $1/8 \gamma H^3$  WHERE  $\gamma = 100$  pcf  
NET MOM = OTM - RESISTING MOMENT

**CASE II**  
OTM =  $1/8 \gamma H^3$  WHERE  $\gamma = 62.4$  pcf  
NET MOM = OTM + RESISTING MOMENT

$$f_s = \frac{M(12 \text{ in/ft})}{A_s j d} = \frac{M(12)}{A_s (0.887) d}$$

$$f_c = \frac{M(2) 12 \text{ in/ft}}{j k b d^2}$$

$$= \frac{M(2)(12)}{(0.887)(0.339)(12) d^2} < 1125 \text{ psi}$$

$$m_c = \frac{(1/2) \gamma H^4}{(12 \text{ in/ft}) j d}$$


$$= \frac{(2)(12)(0.887) d}{\gamma H^4} < 55 \text{ psi}$$

$f_c = 2,500$  psi


$f_s = 20,000$  psi

$f_c = 0.45 f_c = 1125$  psi

$V_c = 1.1 \sqrt{f_c} = 55$  psi

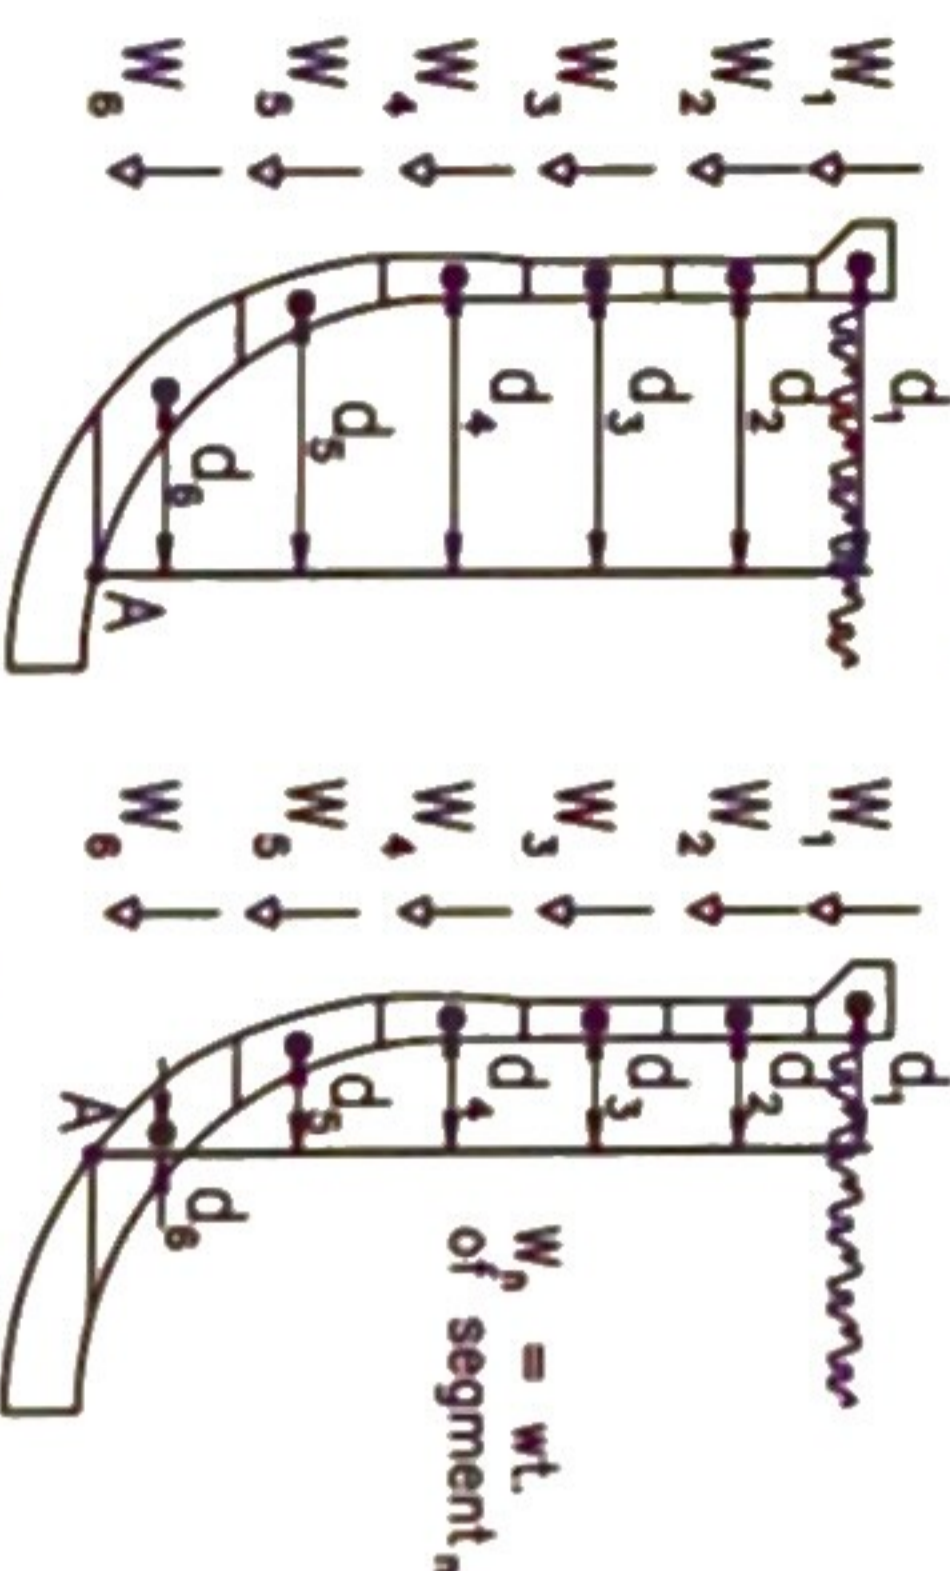

**LOADING DIAGRAM:**  
THIS DETAIL IS DESIGNED FOR EACH OF THE LOAD CASES DEFINED BELOW.

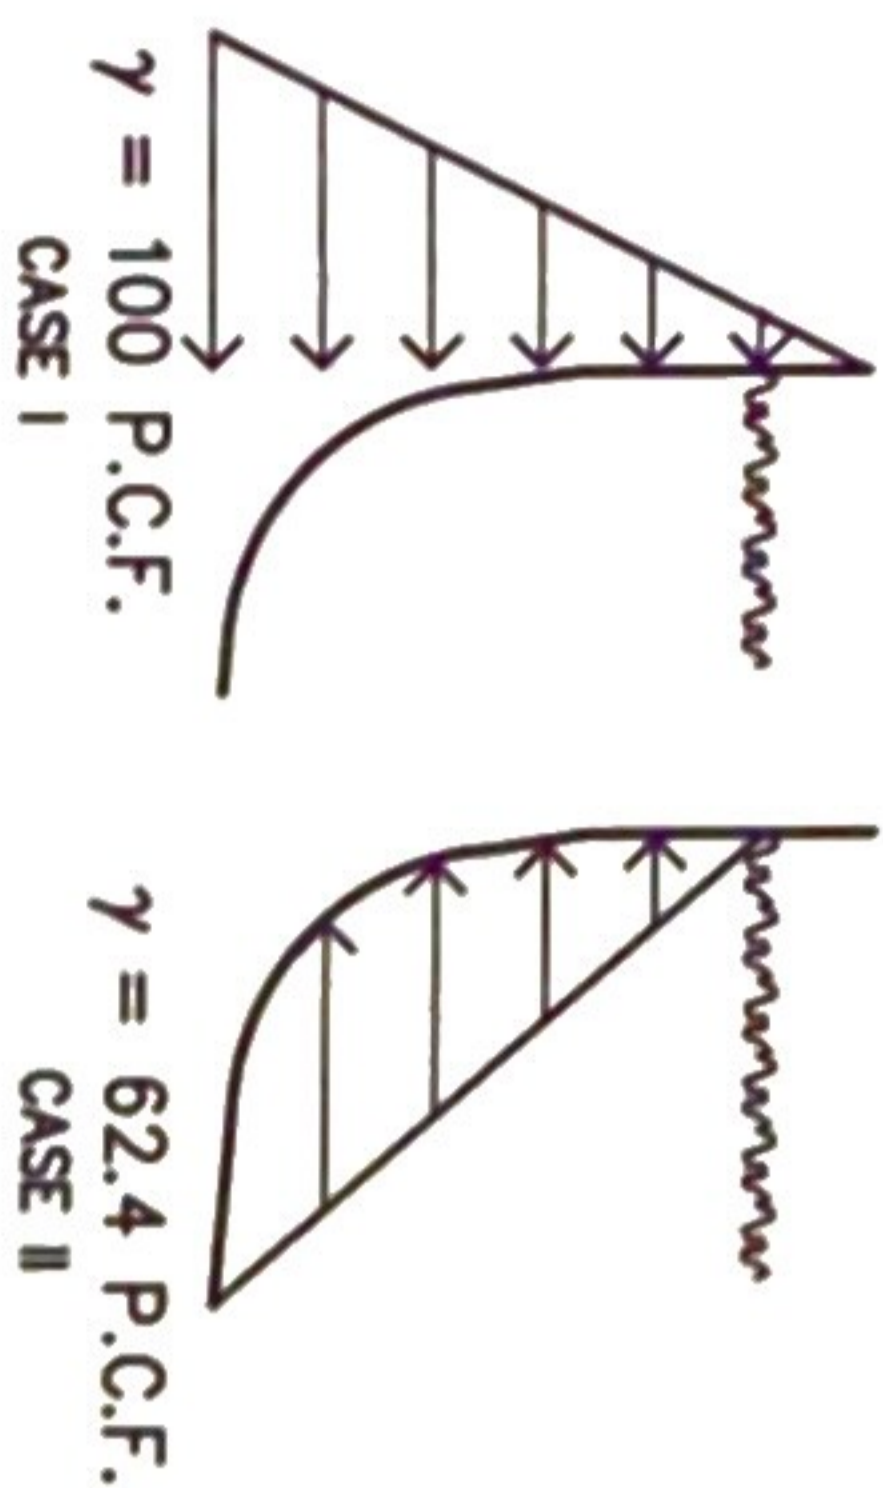


## CALCULATION RESULTS:

STANDARD POOL WALL  
EQUIVALENT FLUID PRESSURE = 100 P.C.F.

HEIGHT H'-ft	SOIL OTM ft-ft	WATER OTM ft-ft	SOIL RM ft-ft	WATER RM ft-ft	NET MOM	t	VERTICAL STEEL	f <sub>s</sub> psi.	f <sub>c</sub> psi.	m <sub>c</sub> psi.
0'-6"	2	1	38	-38	-36	12"	#4 @ 6"	-135	-4	0.1
1'-0"	17	10	75	-75	-65	12"	"	-222	-7	0.5
1'-6"	56	35	113	-113	-77	12"	"	-214	-7	1.1
2'-0"	133	83	150	-150	-67	12"	"	-63	-2	1.9
2'-6"	260	163	188	-188	-25	12"	"	277	9	3.0
3'-0"	450	281	225	-225	56	12"	"	854	27	4.3
3'-6"	715	446	263	-263	183	12"	"	1716	53	5.8
4'-0"	1067	666	300	-300	366	12"	"	2911	91	7.6
4'-6"	1519	948	338	-338	610	12"	"	4485	140	9.6
5'-0"	2083	1300	375	-375	925	12"	"	6486	202	11.9
5'-6"	2773	1730	413	-413	1318	12"	"	8962	279	14.4
6'-0"	3600	2246	450	-450	1796	12"	"	11959	372	17.1
6'-6"	4577	2856	488	-488	2369	12"	"	15527	483	20.1
7'-0"	5717	3567	525	-525	3042	12"	"	19711	613	23.3
7'-6"	7031	4388	712	-494	3893	12"	#4 @ 3"	12359	575	26.8
8'-0"	8533	5325	1923	-502	4823	12"	"	12928	602	30.5

HORIZONTAL BARS MAY BE UNDER OR OVER VERTICAL BARS. ENSURE PROPER CLEARANCES ARE MAINTAINED.

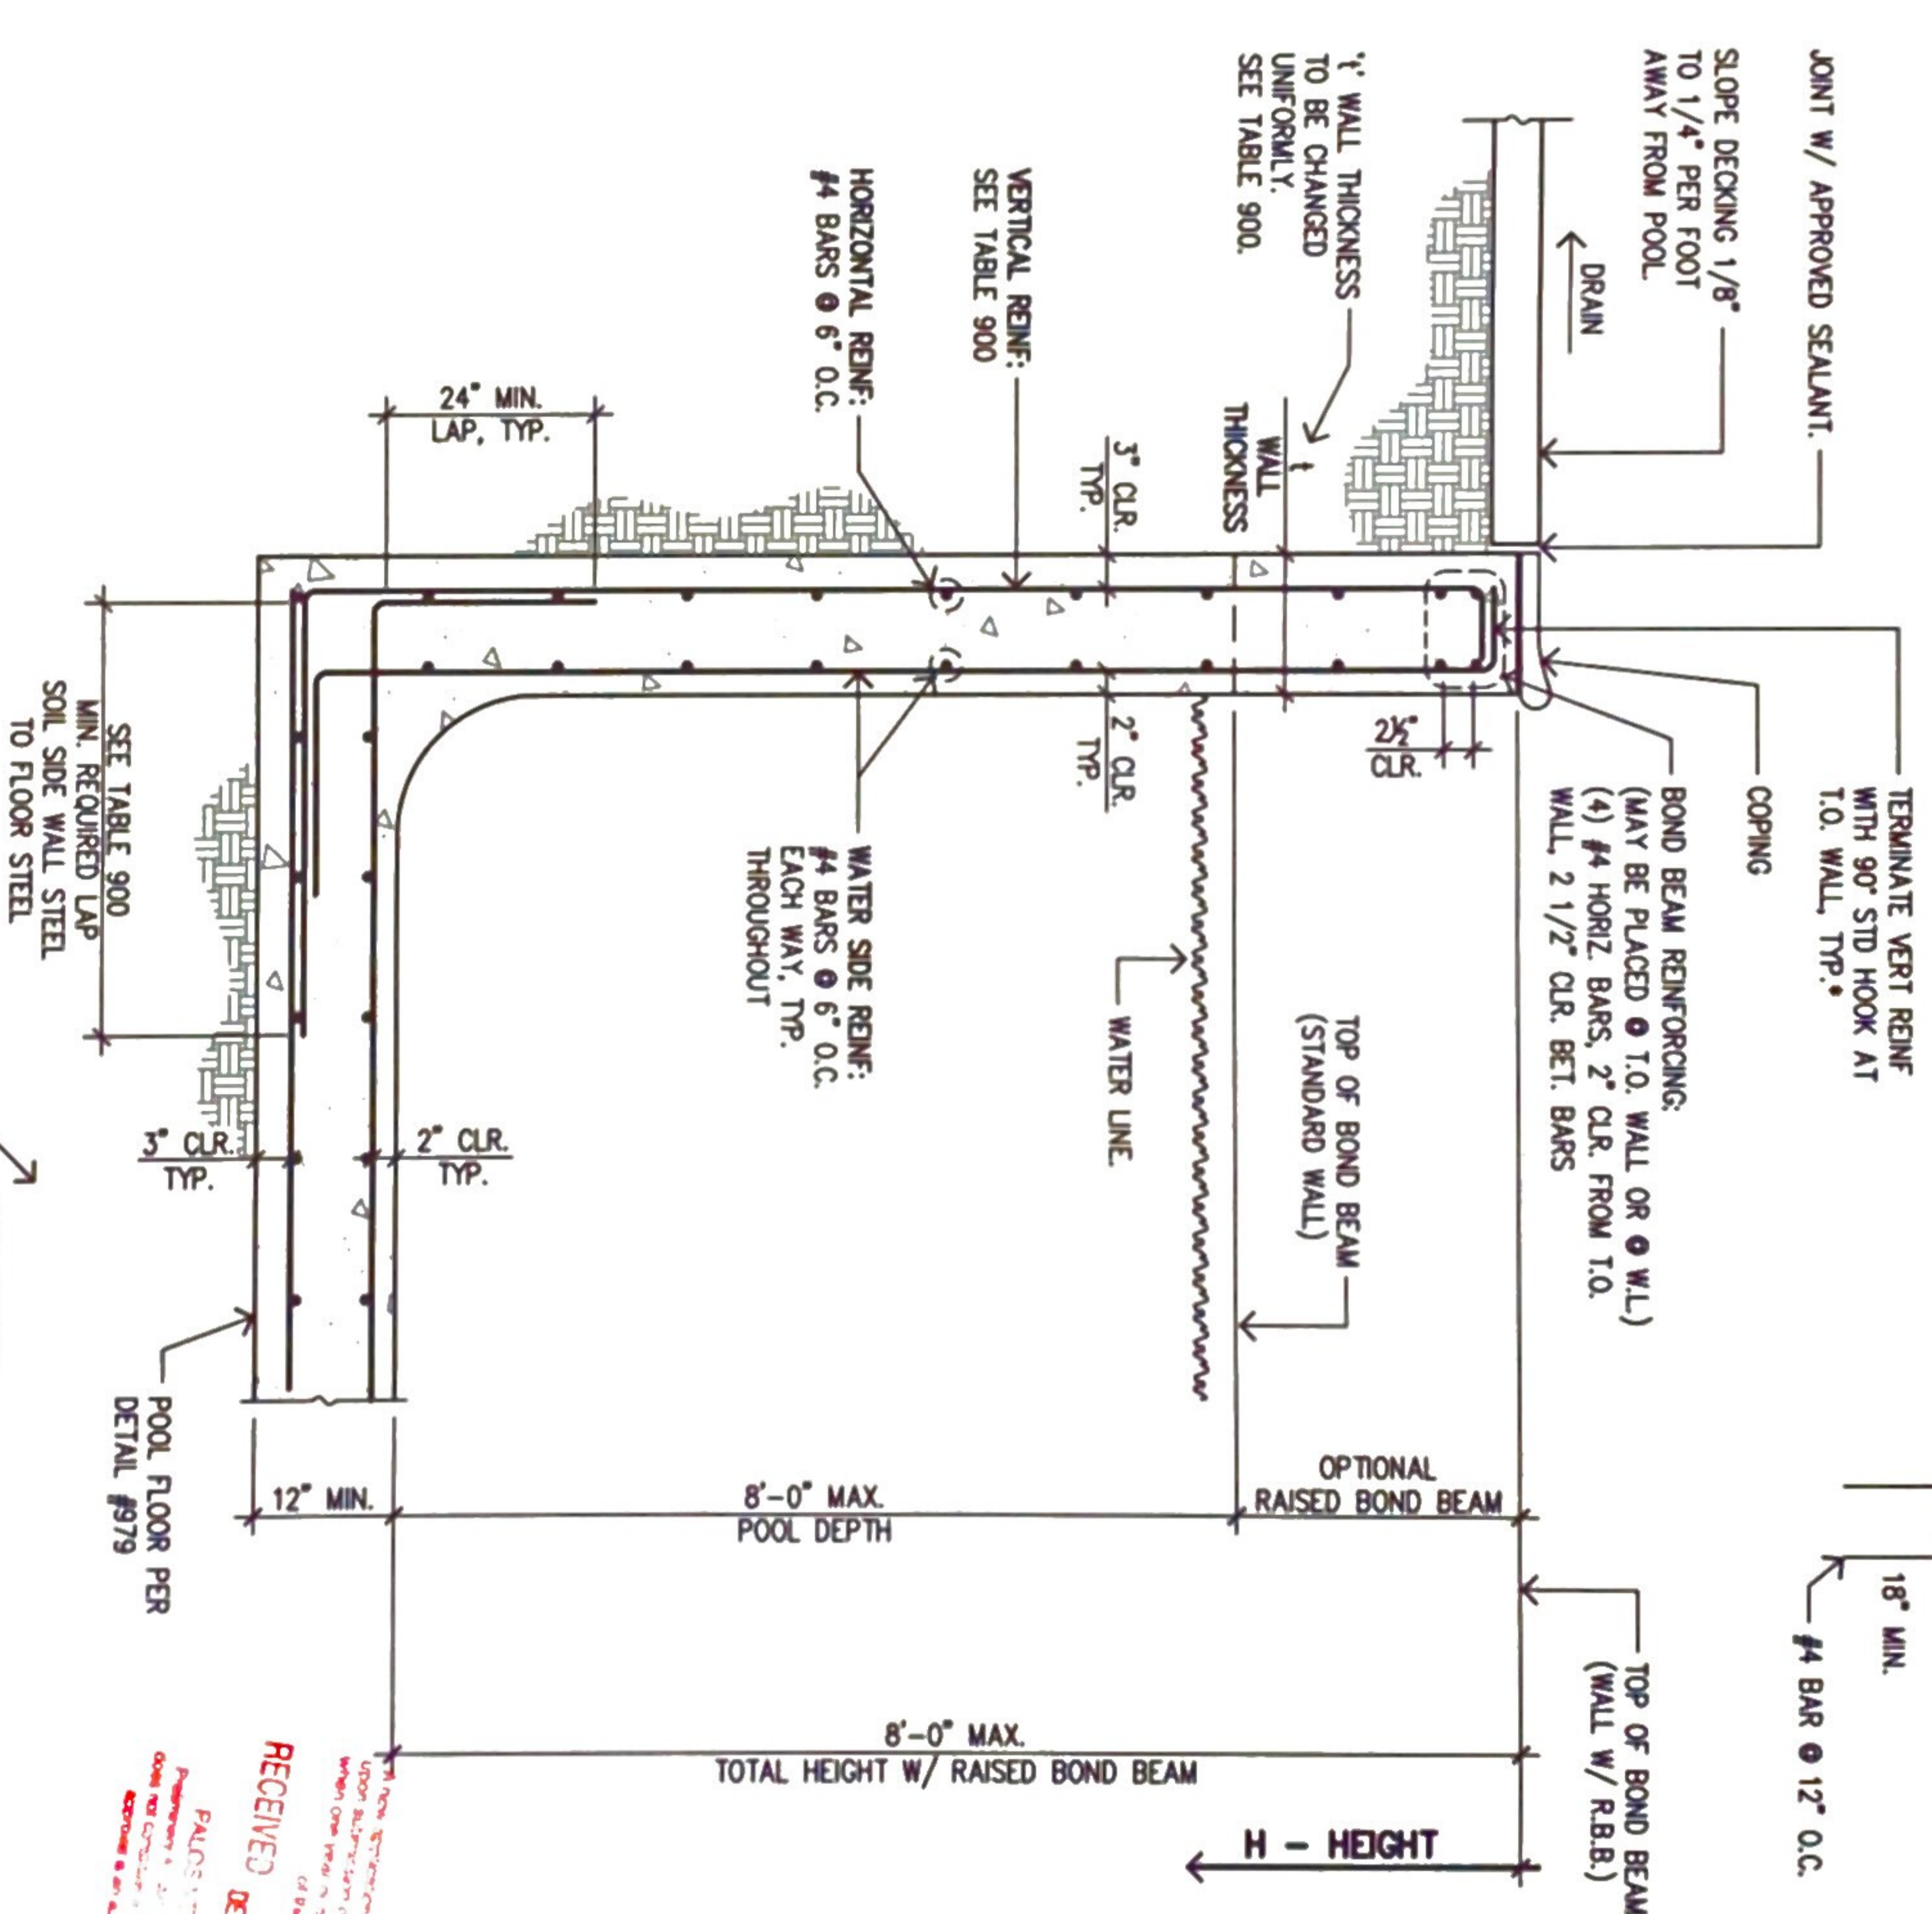


\*OPTIONAL #4 U-BAR @ 12" O.C. MAY BE USED IN LIEU OF 90° STD HKS. LAP 18" MIN. W/ VERT REINF

**TABLE 900**  
H' IS DISTANCE FROM TOP OF POOL WALL DOWNWARD. BEGIN SPECIFIED STEEL & GUNITE THICKNESS AT INDICATED 'H' DEPTH. (SEE STANDARD STRUCTURAL PLAN, DETAIL #2)

TOTAL HEIGHT	POOL WALL SCHEDULE	MIN. REIN. LAP
0 to 0'6"	12"	#4 @ 6"
1'-0"	12"	"
1'-6"	12"	"
2'-0"	12"	"
2'-6"	12"	"
3'-0"	12"	"
3'-6"	12"	"
4'-0"	12"	"
4'-6"	12"	"
5'-0"	12"	"
5'-6"	12"	"
6'-0"	12"	"
6'-6"	12"	"
7'-0"	12"	"
7'-6"	12"	#4 @ 3"
8'-0"	12"	"


- NOTES**
1. ALL STEEL SHALL BE 3" CLR. FROM EARTH.
  2. ALL LAPS TO BE 24" MIN. UNLESS OTHERWISE NOTED.

**FOR USE ONLY AT**  
2357 Via Anacapa  
Palos Verdes Estates CA

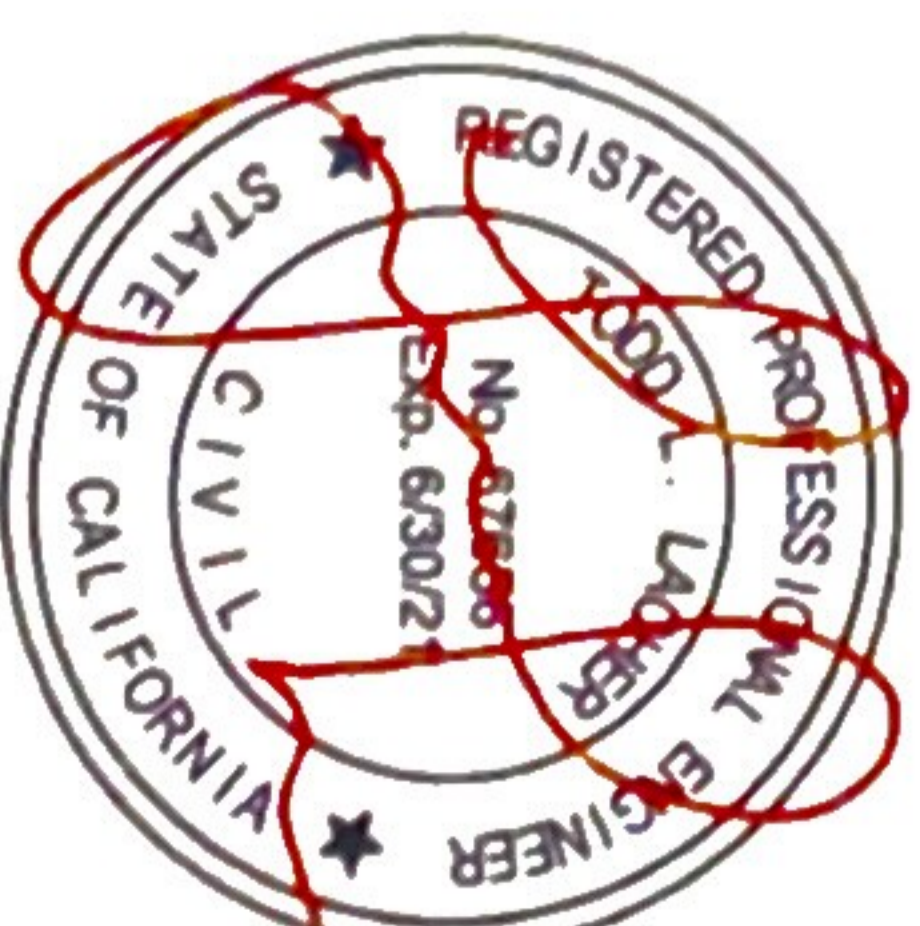

Date: 9/23/2020

PLAN VALID ONLY WITH ENGINEER'S SIGNATURE IN RED INK ON PLAN.  
THIS DETAIL TO BE USED IN CONJUNCTION WITH STANDARD POOL STRUCTURAL PLAN

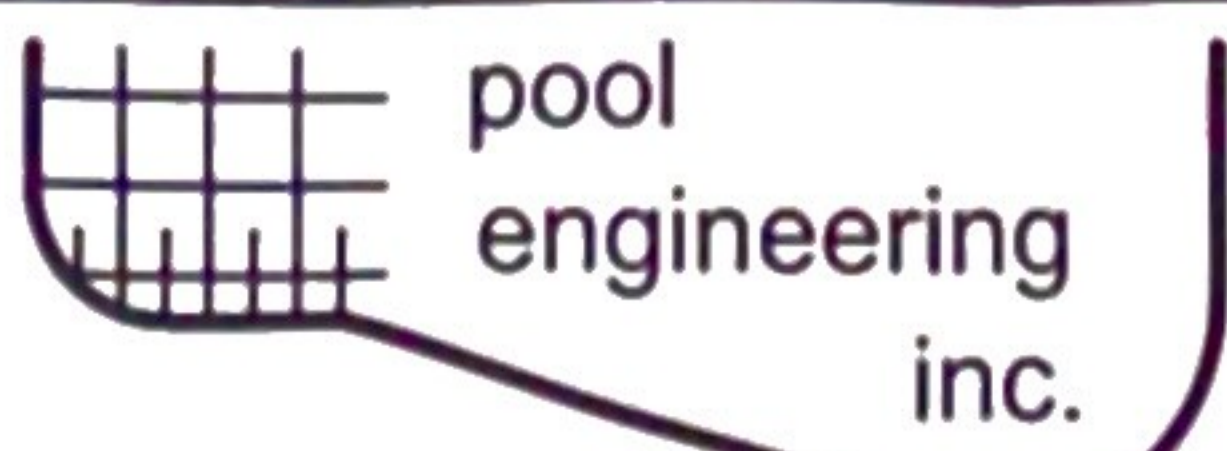

Ron Lacher, R.C.E.  
1201 N. Tustin Ave.  
Anaheim, CA 92807  
Fax: (714) 630-6114  
Phone: (714) 630-6100

**CONSTRUCTION MUST MATCH DRAWN DETAILS EXACTLY**

NOTE: ANY CHANGES TO THE DETAILS OR DESIGNS ON THE EXTERIOR ELEVATIONS TO BE REVIEWED BY THE ART JURY PRIOR TO ANY CHANGES


STANDARD POOL WALL  
EQUIVALENT FLUID PRESSURE = 100 P.C.F.

**DETAIL #900**



REV MAY 2, 2020

LENGTH/WIDTH VARIES  
SEE ARCHITECTURAL PLANS

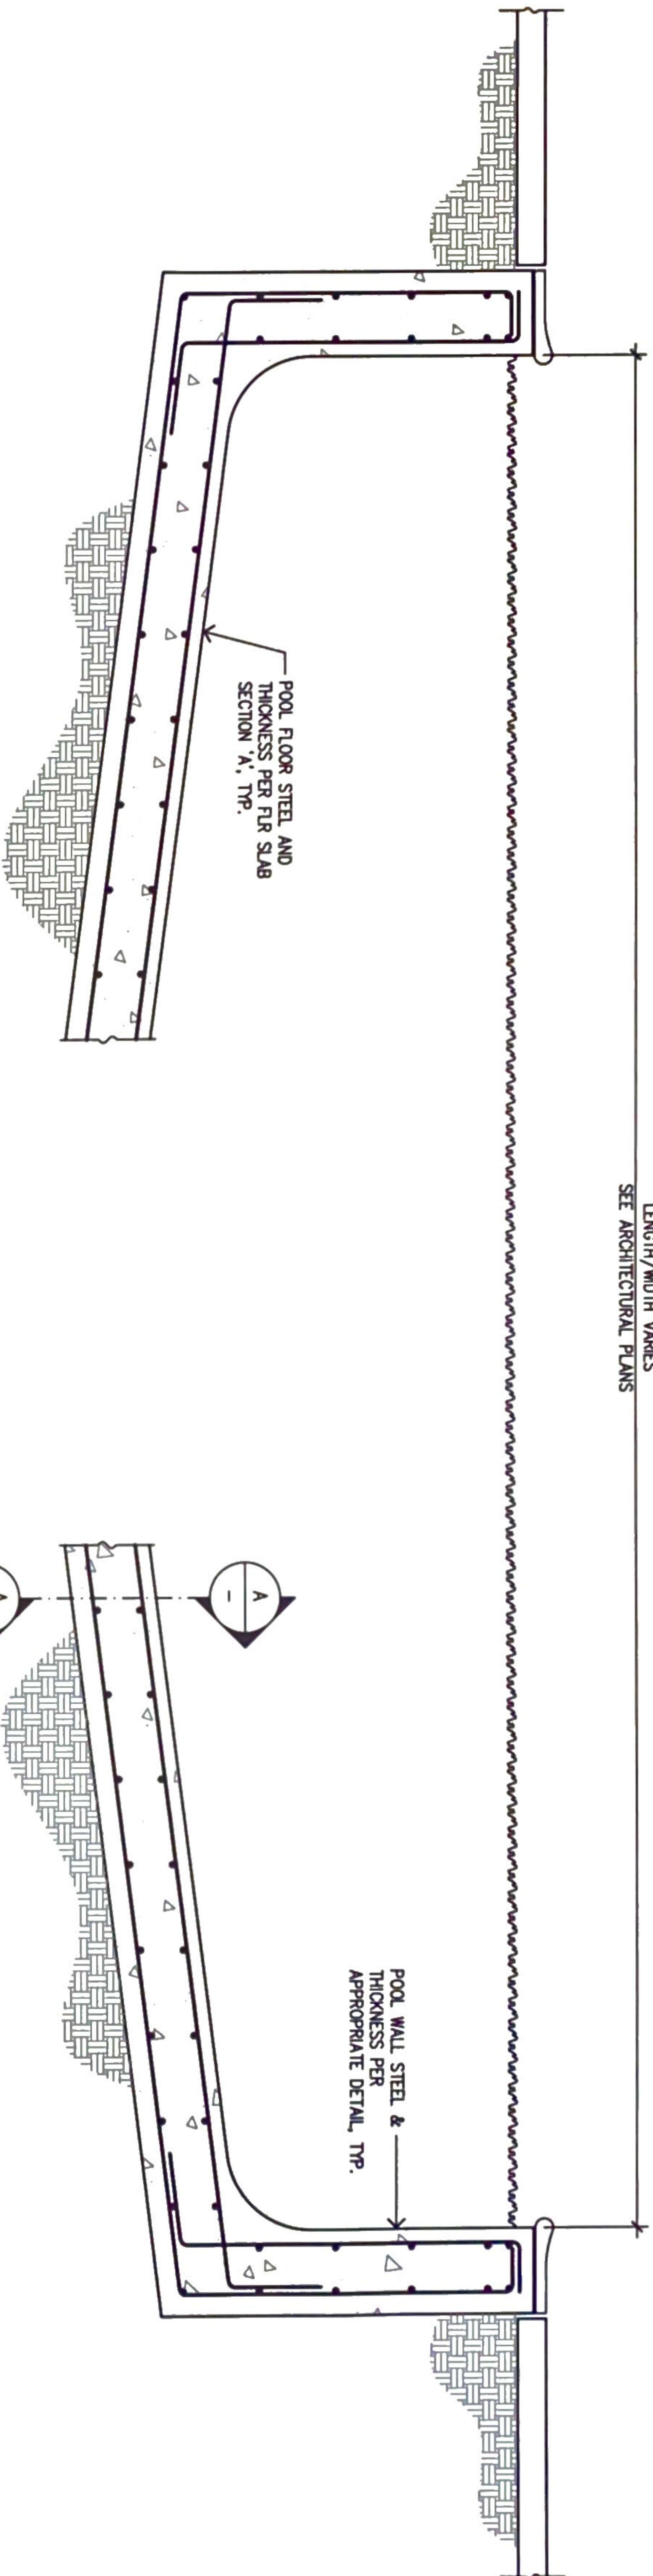


GEOTECHNICAL  
ENGINEER APPROVED  
SUBGRADE

GEOTECHNICAL  
ENGINEER APPROVED  
SUBGRADE

**CONC FLR SLAB SCHEDULE**

THICKNESS	CURTAIN SPACING	T.O. SLAB REINFORCING	B.O. SLAB REINFORCING
12"	7"	#4 @ 6" O.C.	#4 @ 6" O.C.

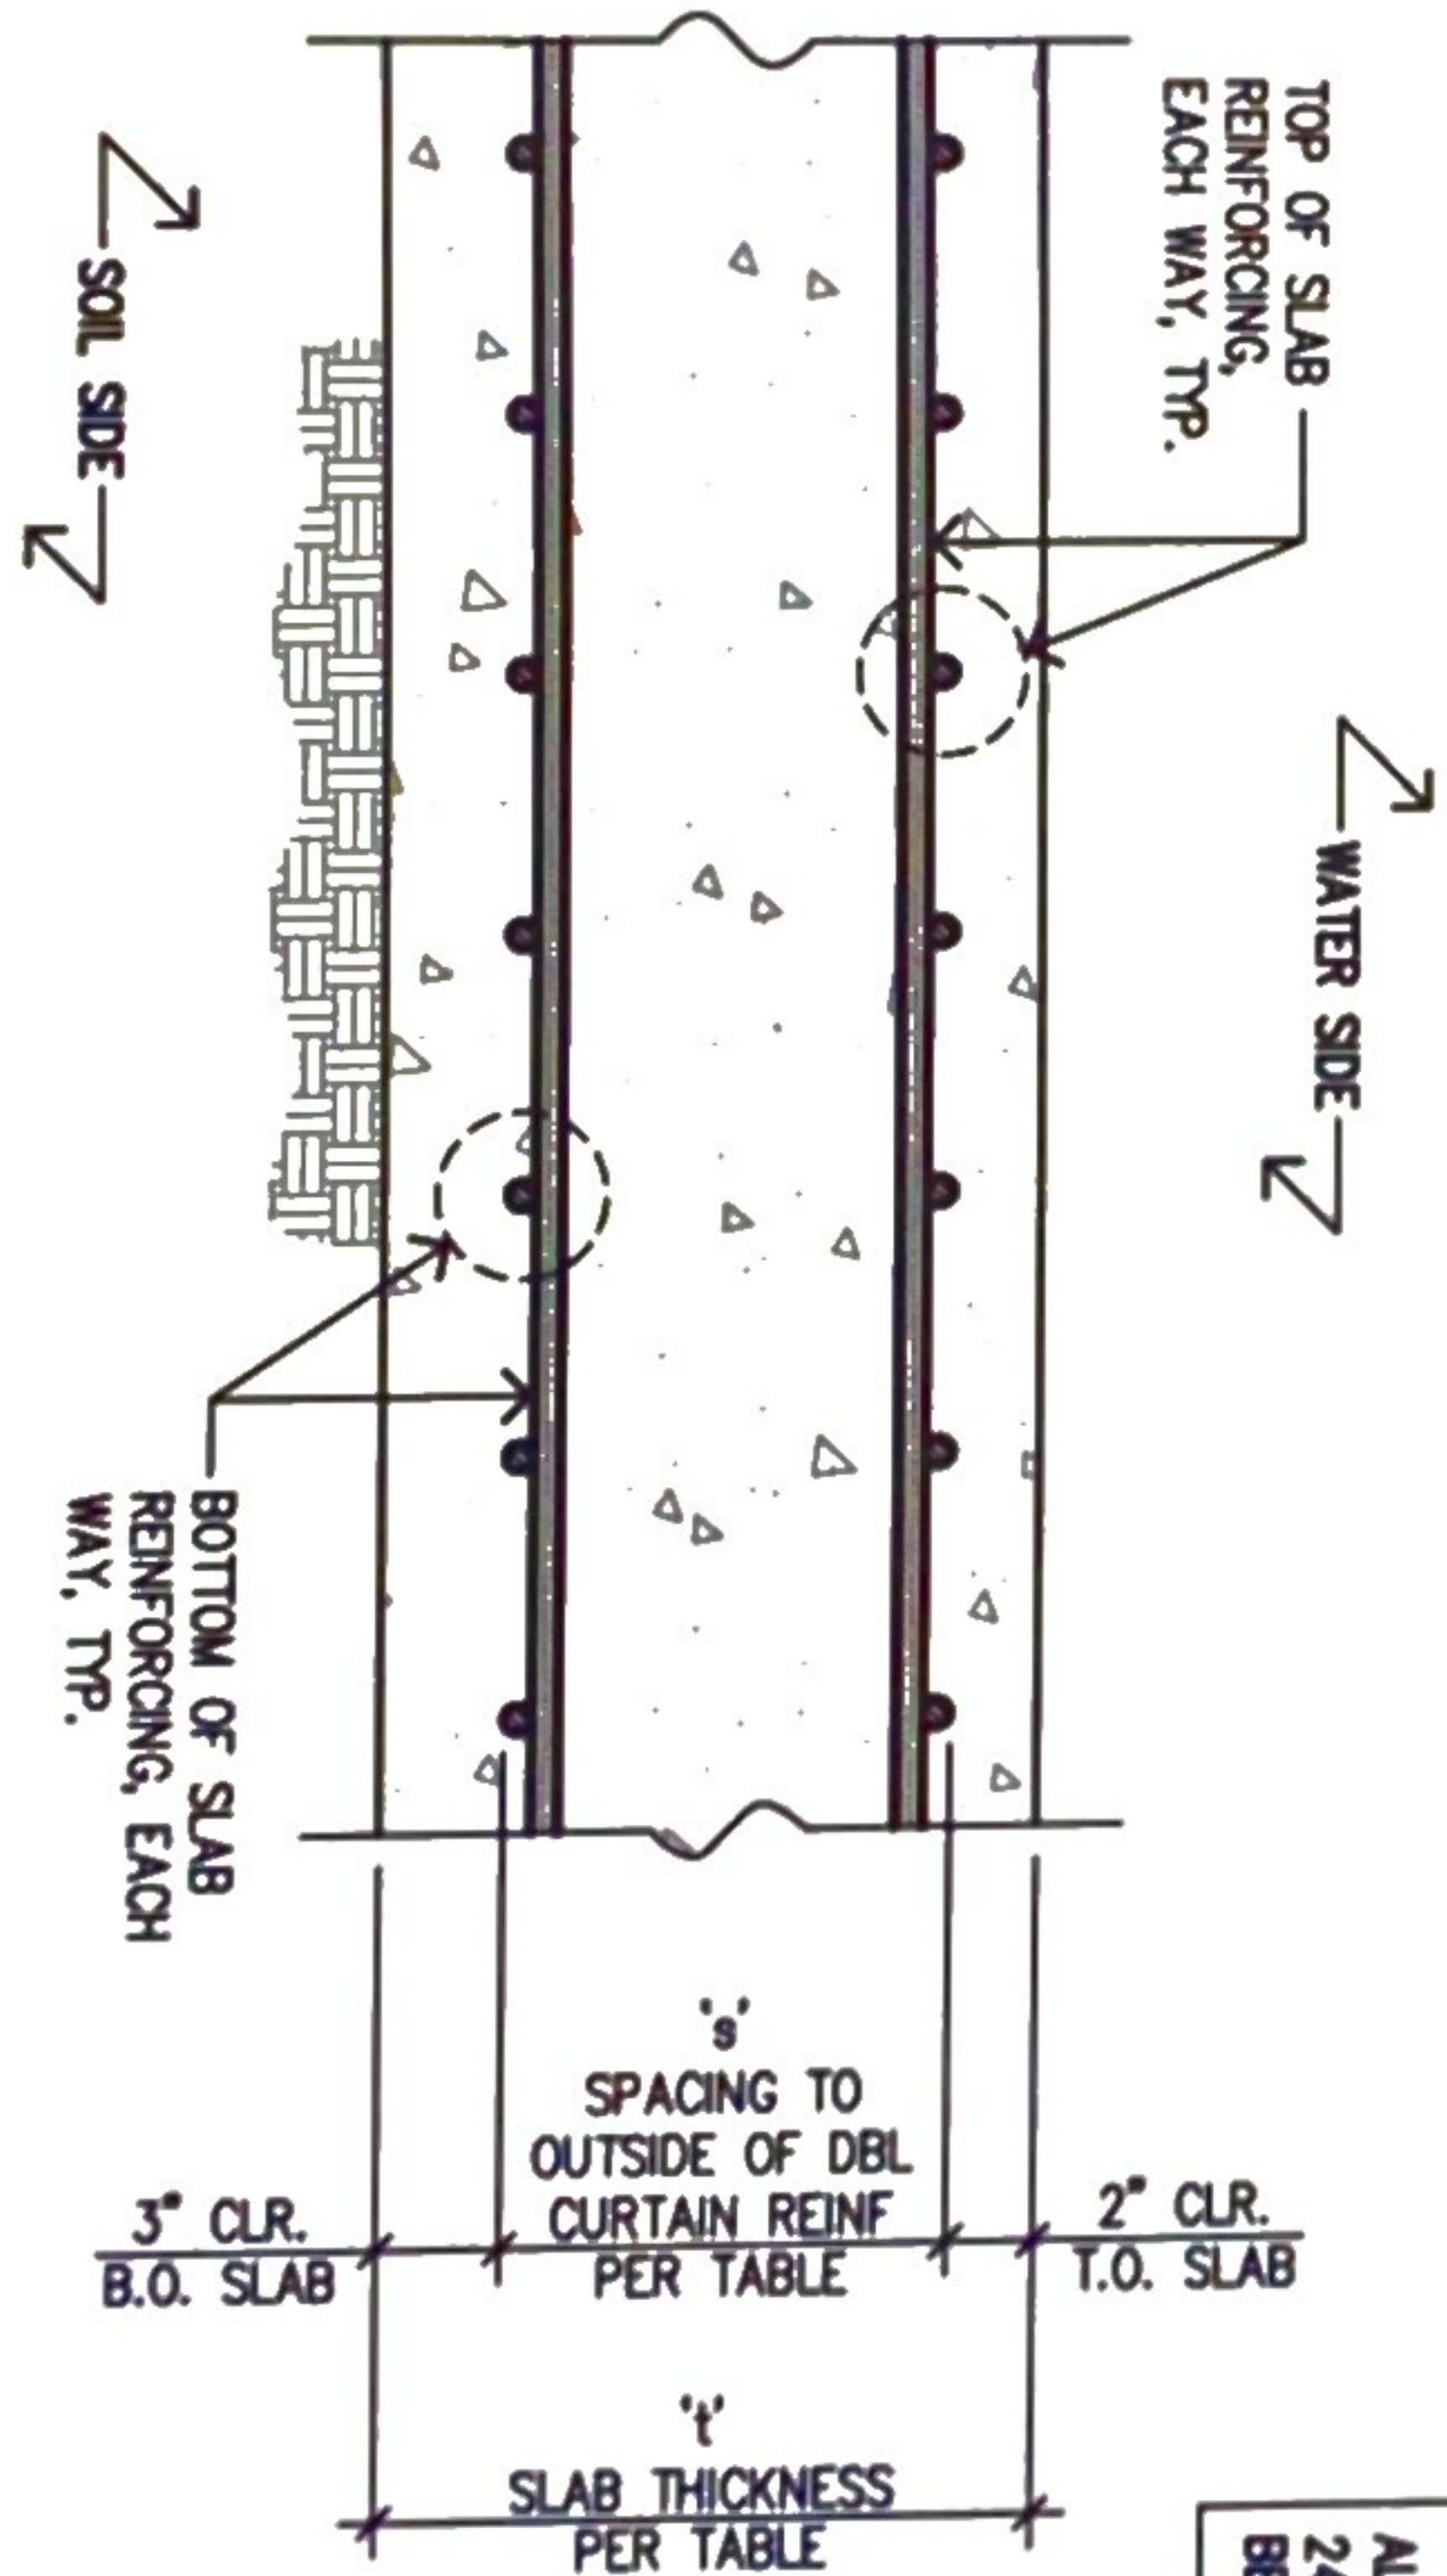

SECTION VIEW  
NO SCALE


A

ALL LAPS SHALL BE  
24" MIN. AND SHALL  
BE WELL STAGGERED.

NOTE: ANY CHANGES TO THE  
DETAILS OR DESIGNS ON THE  
EXTERIOR ELEVATIONS  
TO BE REVIEWED BY THE ART  
JURY PRIOR TO ANY CHANGES

**CONSTRUCTION  
MUST MATCH  
DRAWN DETAILS  
EXACTLY**


RECEIVED  
DEC 14 2020  
RECEIVED  
Palos Verdes Estates CA  
Date: 9/23/2020

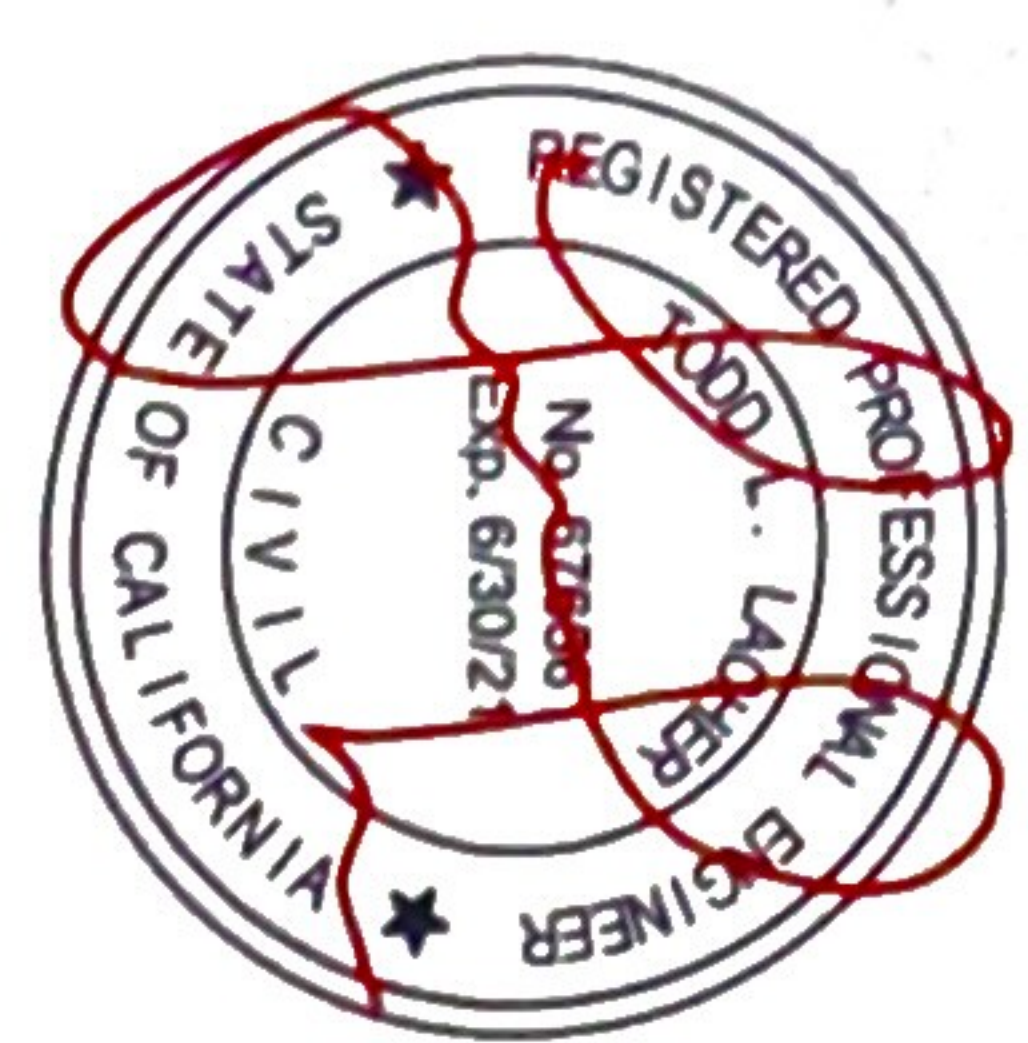

**FOR USE ONLY AT**  
2357 Via Anacapa  
Palos Verdes Estates CA

PLAN VALID ONLY WITH ENGINEER'S  
SIGNATURE IN RED INK ON PLAN.

THIS DETAIL TO BE USED IN CONJUNCTION  
WITH STANDARD POOL STRUCTURAL PLAN

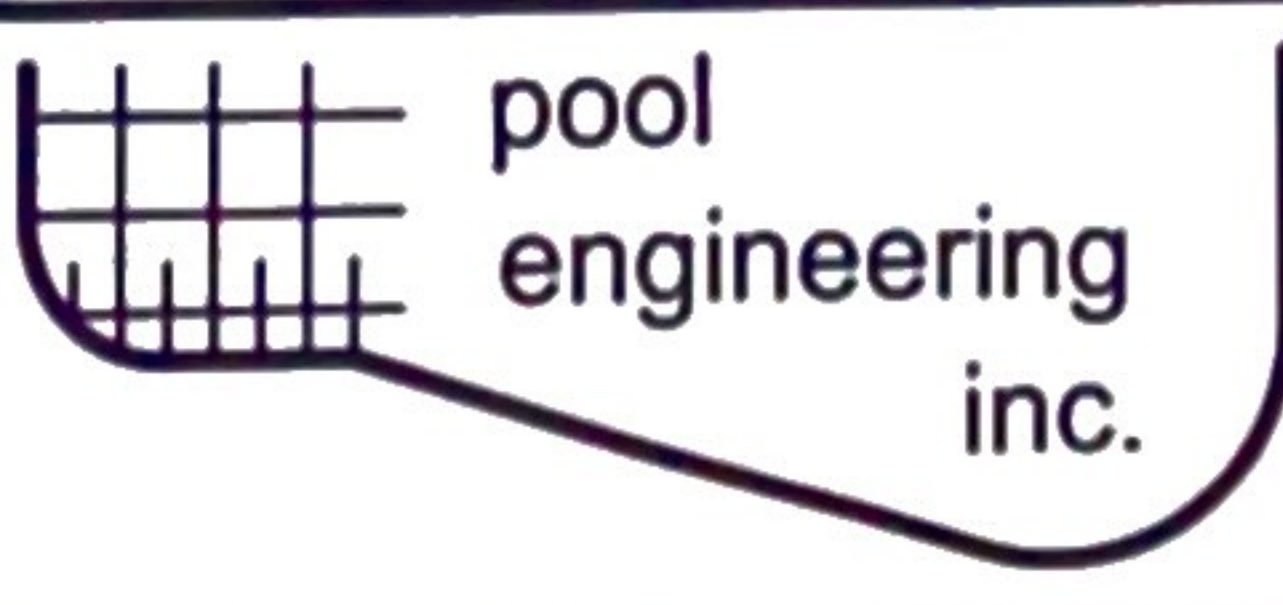

Ron Lacher, R.C.E.  
1201 N. Tustin Ave.  
Anaheim, CA 92807  
Fax: (714) 630-6114  
Phone: (714) 630-6100

12" THICK POOL FLOOR  
W/ DOUBLE CURTAIN REINFORCING

**DETAIL #979**



STANDARD POOL STRUCTURAL PLAN, STRUCTURAL NOTE #1 IS REPEATED HERE  
FOR EMPHASIS:  
1. SOIL SHALL HAVE A MINIMUM BEARING VALUE OF 1500 P.S.F. CONCRETE SHALL  
BE PLACED AGAINST UNDISTURBED SOIL OR BUILDING DEPARTMENT APPROVED  
90% COMPACT FILL. THIS PLAN IS NOT SUITABLE WHERE POTENTIAL EXISTS  
FOR DIFFERENTIAL MOVEMENT FROM DISSIMILAR SOIL CONDITIONS UNDER POOL,  
SUCH AS CUT-FILL TRANSITIONS.